
ROOF LAYOUT - REFERENCE OVERLAYS

ENGINEER-MARKED WALL REFERENCES | WRITTEN SURVEY DIMENSIONS GOVERN | NTS | FOR REVIEW

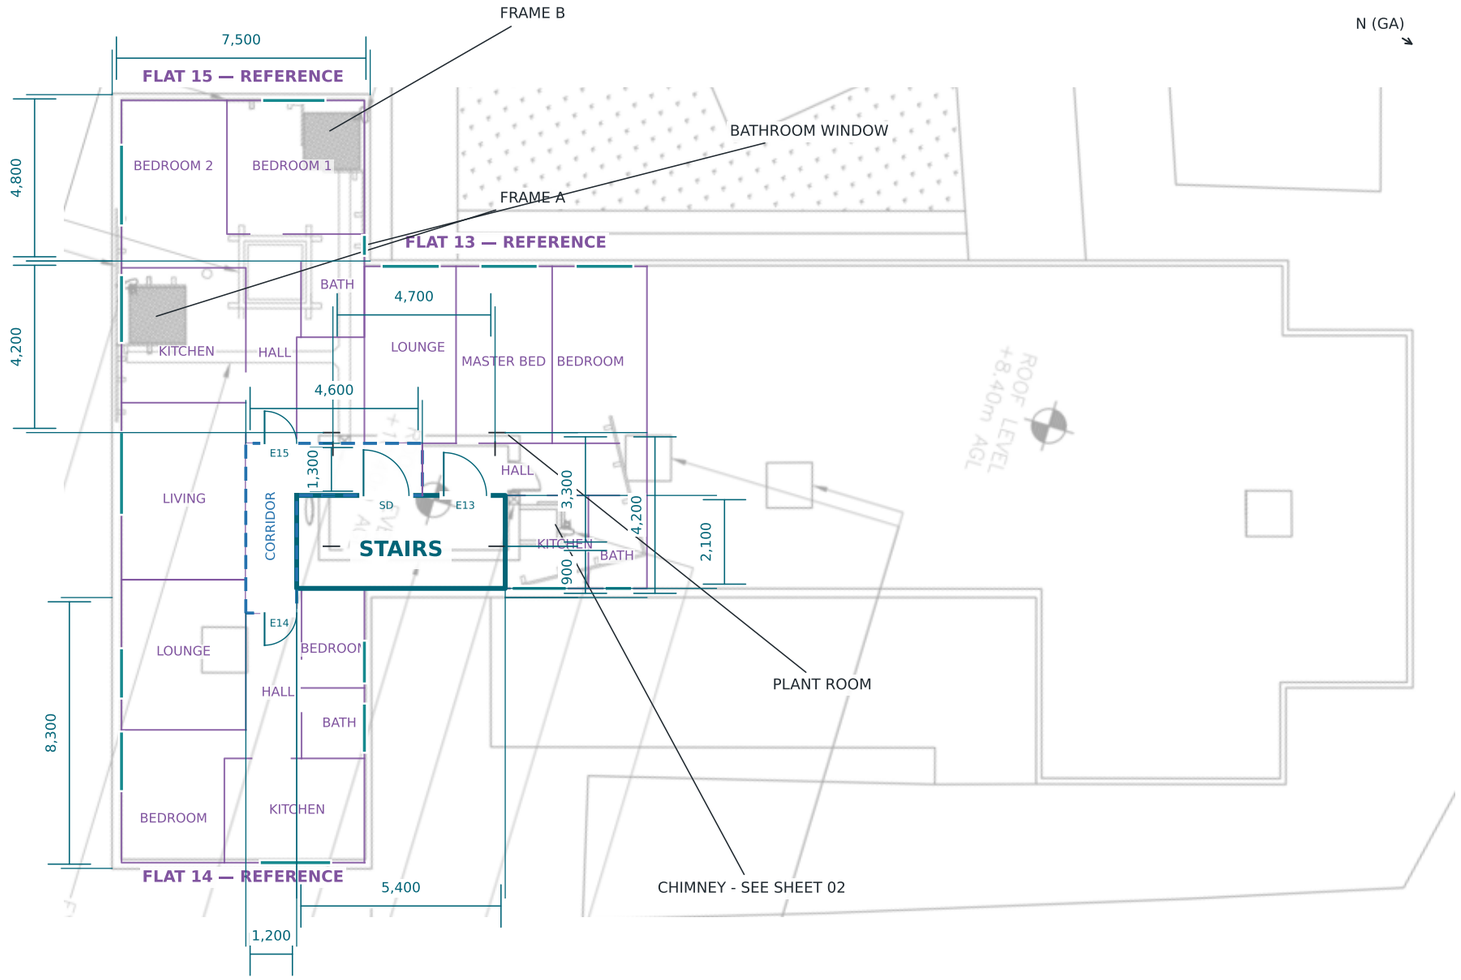

ALL DIMENSIONS IN mm. DIMENSION EXTENSIONS IDENTIFY THE REFERENCE FACES. DO NOT SCALE.

Sources: Survey Notes pp2-3; GA 200 Rev 1A (PDF p5); engineer boundary/corridor/window markup and exterior photographs.

ALL DIMENSIONS IN mm UNLESS STATED OTHERWISE

NOTES:

1. Top-floor flats 13-15 were inaccessible. Apartment plans are third-party references, not surveyed structure.

2. Written survey dimensions govern. Apartment partitions are approximate graphic references. Do not scale.

3. Stairs have separate doors to common corridor (SD) and flat 13 (E13). E14/E15 mark other flat entrances.

4. Plant room is above the flat/stair layout. Its face marks identify dimension references. Door/window sizes and swings schematic.

5. Plant-room wall thickness: 280 mm. Equipment/frame sizes and anchors unverified. Chimney elevations: sheet 02.

STRUCTURAL MEMBER KEY

- Load-bearing stair walls / Engineer-described survey line
- Non-load-bearing corridors
- Apartment reference partitions / Structural status unverified
- Window reference from plan / Photo association, not measured
- Client GA / existing equipment
- Door leaf / swing (schematic)

Window marks are reference positions only.

P07	DIMENSIONS	TBC	TBC	23-10-2026
Rev:	Issue:	Drawn:	Chkd:	Date:

Consultant:

KA ENGINEERING GROUP

Client:

Connect44

Job Title:

ROOF STRUCTURAL SURVEY

Drawing Title:

ROOF LAYOUT - REFERENCE OVERLAYS

Address:

HONEYPOT HALL
HAROLD ROAD
CLACTON-ON-SEA, ESSEX
CO15 6AL

Drawn By:	Checked By:
TO CONFIRM	TO CONFIRM
Scale at A3:	**Date (reference sheet):**
NTS / DO NOT SCALE	23-10-2026

Project No:	Drawing No:	Rev:
7111	7111-01	P07