
ROOF LAYOUT - REFERENCE OVERLAYS

ENGINEER-MARKED WALL REFERENCES | WRITTEN SURVEY DIMENSIONS GOVERN | NTS | FOR REVIEW

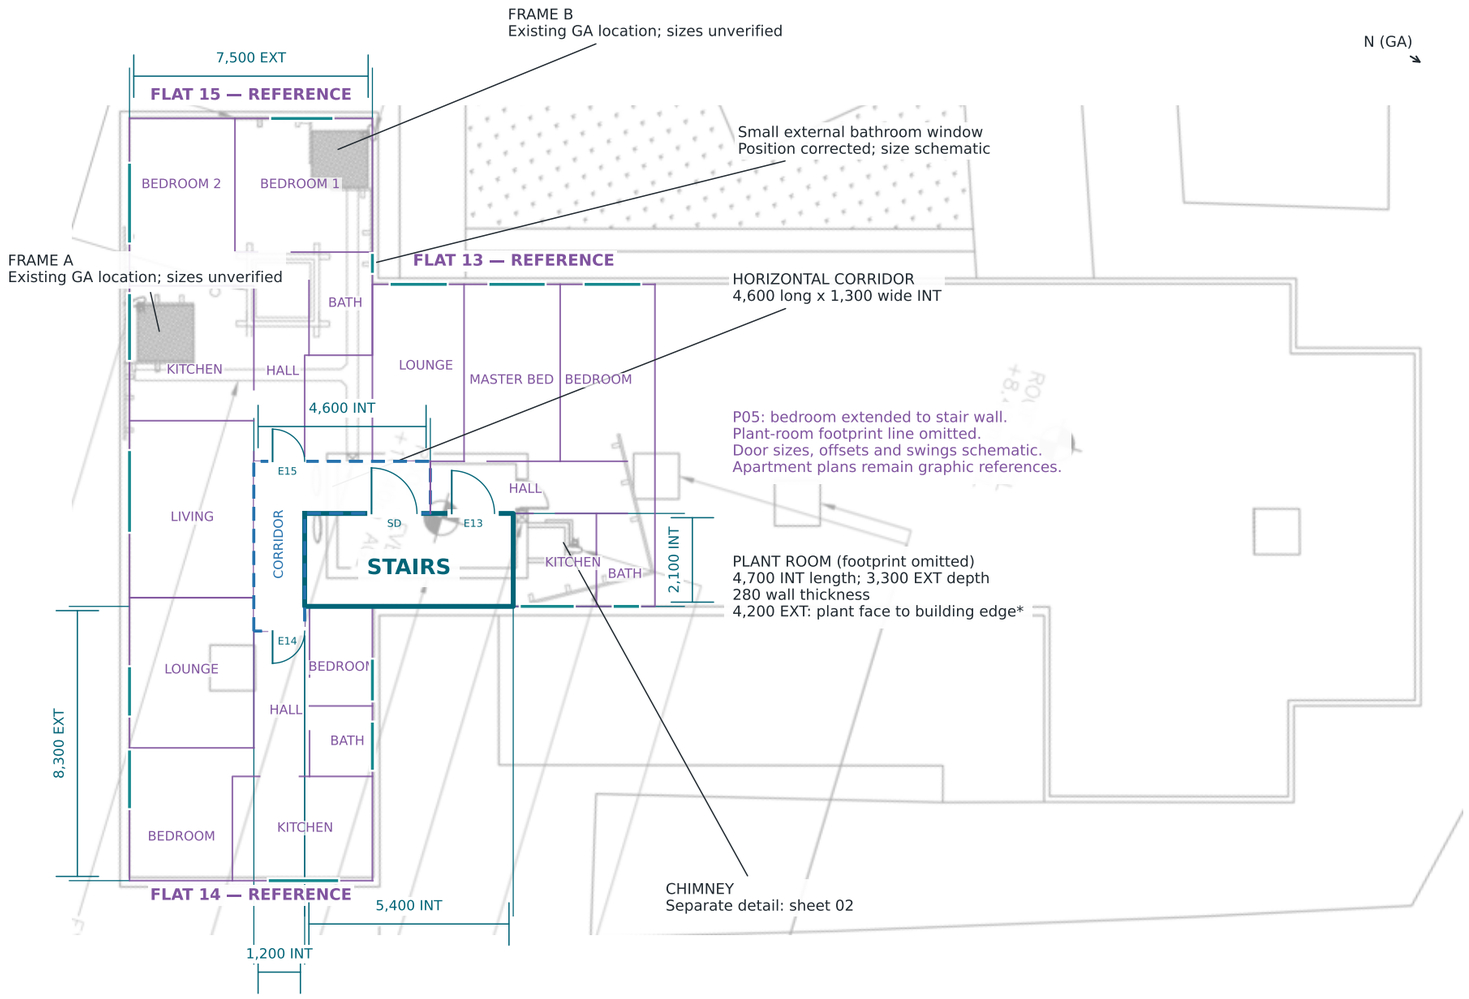

DIMENSION REFERENCES:

Stairwell: 5,400 x 2,100 INT. Upper corridor: 4,600 x 1,300 INT. Left corridor: 1,200 INT wide.
*Plant face to building edge: 4,200 EXT; starting face awaits confirmation.
Separate upper 4,200 EXT source label retained for review: endpoints not yet established.

Dimensions are written survey values, not PDF-scaled lengths. Purple room lines are approximate website-plan references, not surveyed partitions.

INT = INTERNAL FACES; EXT = EXTERNAL FACES. VALUES IN mm; NTS. UNRESOLVED ENDPOINTS LISTED ON SHEET.

Sources: Survey Notes pp2-3; GA 200 Rev 1A (PDF p5); engineer boundary/corridor/window markup and exterior photographs.

ALL DIMENSIONS IN mm UNLESS STATED OTHERWISE

NOTES:

1. Top-floor flats 13-15 were inaccessible. Apartment plans are third-party references, not surveyed structure.

2. Internal overlay re-anchored to the wall lines marked by the engineer. Graphic fit is not a measured flat layout.

3. Stairs have separate doors to common corridor (SD) and flat 13 (E13). E14/E15 mark other flat entrances.

4. Plant-room footprint omitted as requested. Bedroom 14 extends to stair wall. Door/window sizes and swings schematic.

5. Stairwell 5,400 x 2,100 INT confirmed. Remaining dimension endpoints listed on drawing. Frame sizes/anchors unverified. Chimney: sheet 02.

STRUCTURAL MEMBER KEY

- Load-bearing stair walls — Engineer-described survey line
- Non-load-bearing corridors
- Apartment reference partitions — Structural status unverified
- Window reference from plan — Photo association, not measured
- Client GA / existing equipment
- Door leaf / swing (schematic)

Window marks are reference positions only.

P05	ROOM / DIMS	TBC	TBC	23-10-2026
Rev:	Issue:	Drawn:	Chkd:	Date:

Consultant:

KA ENGINEERING GROUP

Client:

Connect44

Job Title:

ROOF STRUCTURAL SURVEY

Drawing Title:

ROOF LAYOUT - REFERENCE OVERLAYS

Address:

HONEYPOT HALL
HAROLD ROAD
CLACTON-ON-SEA, ESSEX
CO15 6AL

Drawn By:	Checked By:
TO CONFIRM	TO CONFIRM
Scale at A3:	Date (reference sheet):
NTS / DO NOT SCALE	23-10-2026

Project No:	Drawing No:	Rev:
7111	7111-01	P05