
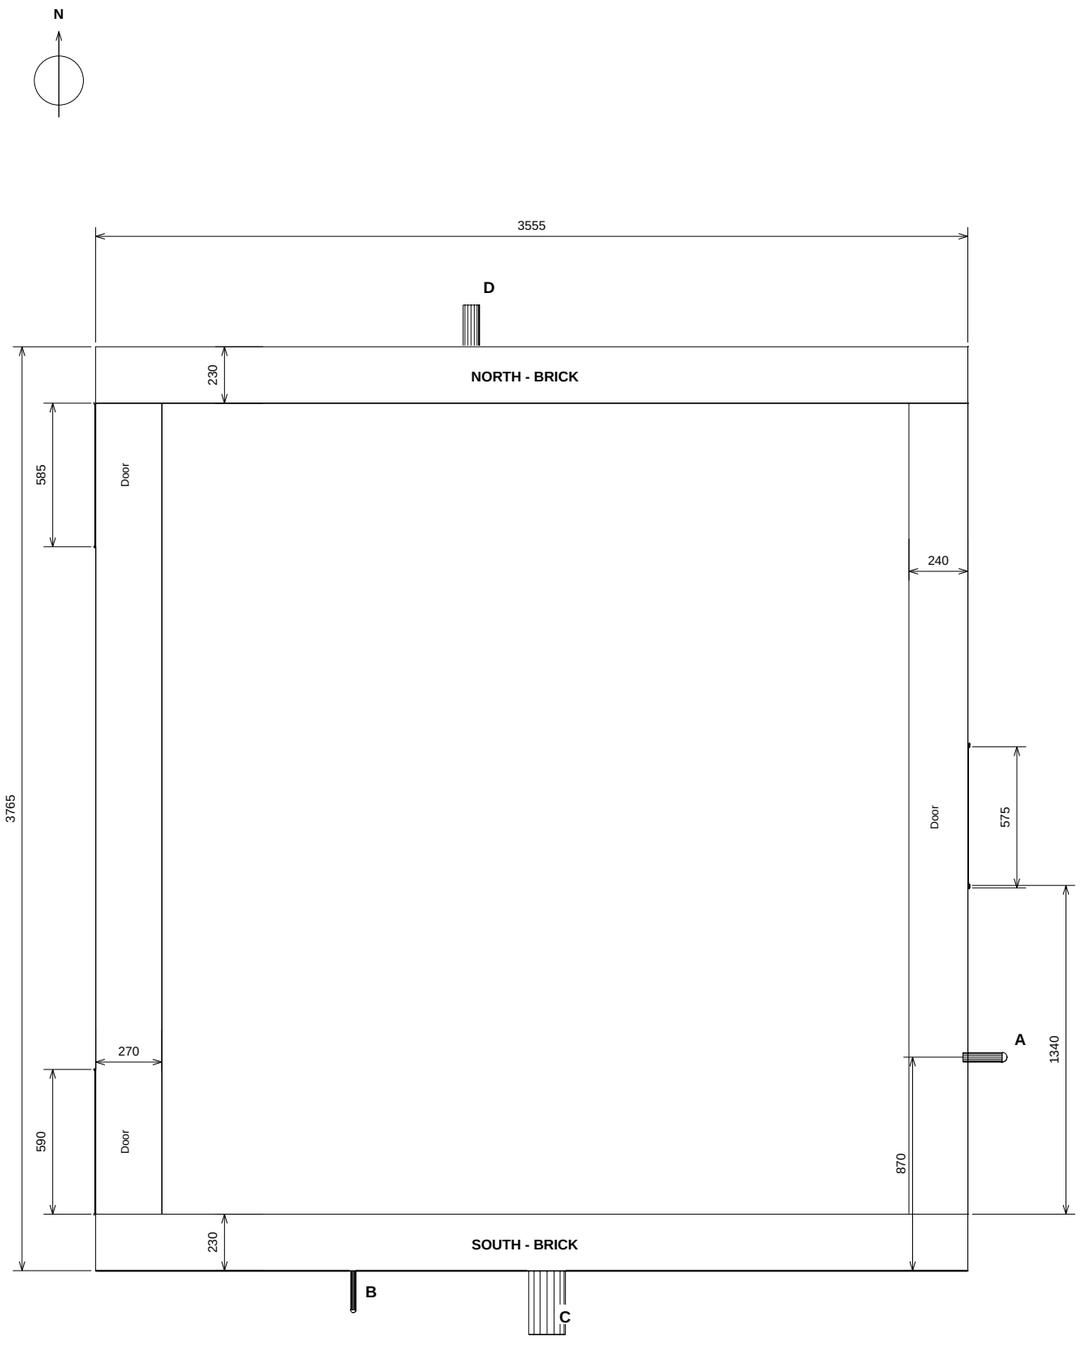



1 **Plant-Room Plan**

1 : 25 | Roof omitted

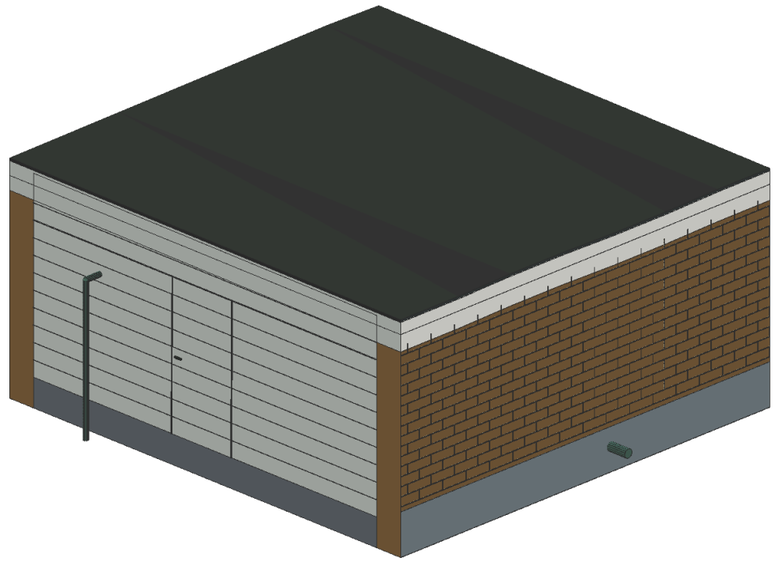

2 **North-East 3D View**

NTS

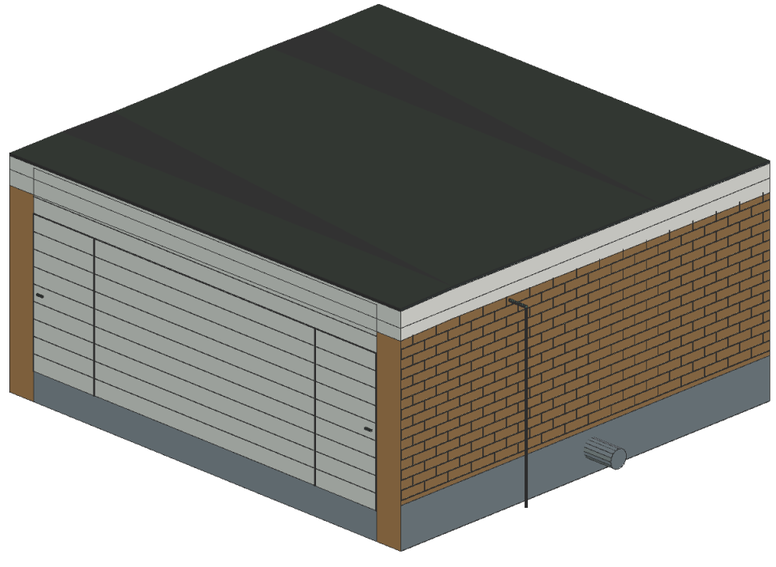

3 **South-West 3D View**

NTS

DIMENSIONS IN mm; LEVELS RELATIVE TO MAIN ROOF

DRAWING NOTES

1. Existing tank room. Datum: main roof = 0.000.

2. North/south walls: brickwork. East/west walls: timber/cladding on raised kerbs.

3. Pipe A: centre 1200 above main roof. Pipe B-D heights shown diagrammatically.

4. Proposed steel frame, grillage and south bird-box boarding excluded.

ELEMENT KEY

Brick walls: 230 thick

Brick top: 1660 above main roof

West kerb: 270 wide x 230 high

East kerb: 240 wide x 230 high

Lead upstand: 340 high

Fascia: 240 deep

Rev	Issue	Drawn	Chkd	Date
TBC	REVIEW	ST	AF	01-11-26

Consultant:

KA ENGINEERING GROUP

Client: JetNSL

JET network solutions

Drawing Title:

Tank Room - Plan / 3D

HOWMIC COURT


EXISTING WATER TANK ROOM

Drawn: ST Checked: AF

Plan 1:25 at A3 / 3D NTS


Project: 7092 Dwg: 7092-01

Revision: TBC

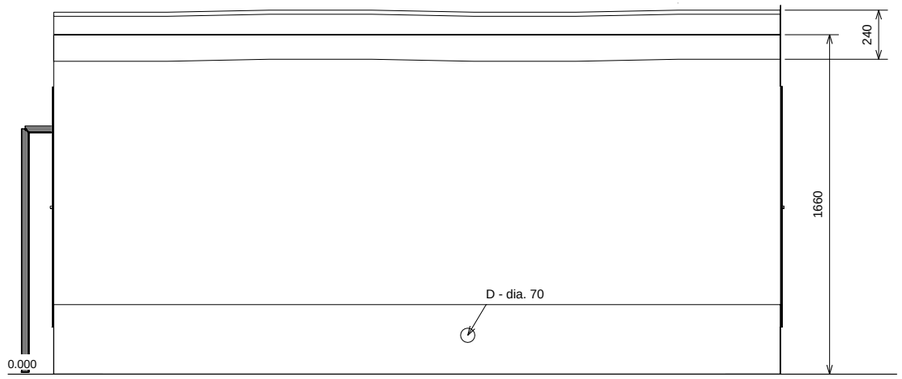


1 **North Elevation**

1 : 30

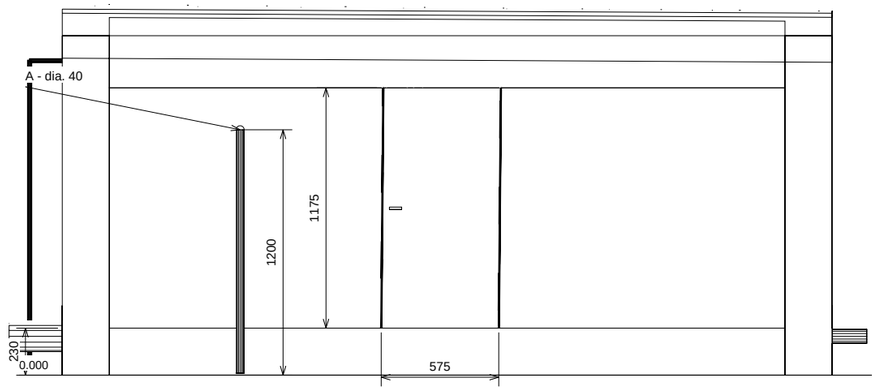

2 **East Elevation**

1 : 30

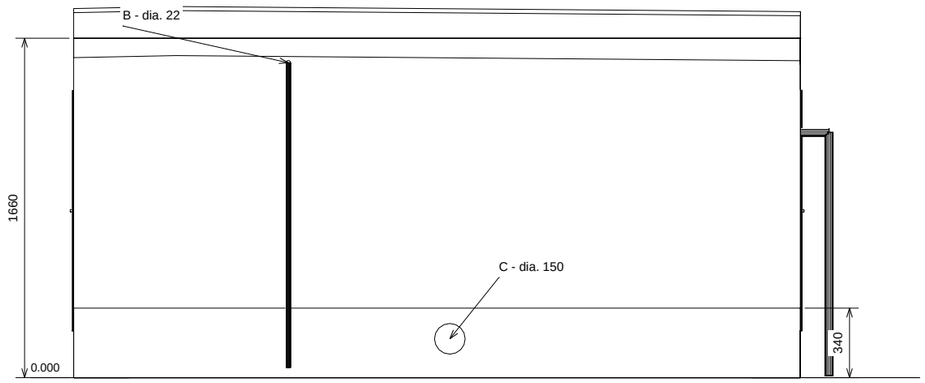

3 **South Elevation**

1 : 30



4 **West Elevation**

1 : 30

DIMENSIONS IN mm; LEVELS RELATIVE TO MAIN ROOF

DRAWING NOTES

1. Existing tank room. Datum: main roof = 0.000.

2. North/south walls: brickwork. East/west walls: timber/cladding on raised kerbs.

3. Pipe A: centre 1200 above main roof. Pipe B-D heights shown diagrammatically.

4. Proposed steel frame, grillage and south bird-box boarding excluded.

ELEMENT KEY

Brick walls: 230 thick

Brick top: 1660 above main roof

West kerb: 270 wide x 230 high

East kerb: 240 wide x 230 high

Lead upstand: 340 high

Fascia: 240 deep

Rev	Issue	Drawn	Chkd	Date
TBC	REVIEW	ST	AF	01-11-26

Consultant:

KA ENGINEERING GROUP

Client: JetNSL

JET network solutions

Drawing Title:

Tank Room - Elevations

HOWMIC COURT

EXISTING WATER TANK ROOM

Drawn: ST Checked: AF

Elevations 1:30 at A3

Project: 7092 Dwg: 7092-02

Revision: TBC

DIMENSIONS IN mm; LEVELS RELATIVE TO MAIN ROOF

ROOF-TOP LEVELS ABOVE MAIN ROOF

Station from W	North	South	Units
0	1780	1805	mm
500	1780	1815	mm
1000	1770	-	mm
1500	1770	-	mm
2000	1780	-	mm
2500	1780	-	mm
3000	1770	-	mm
3555	1770	1790	mm

Stations measured from west end. Roof-top datum, not brick head.

EAST DOOR - SURVEY OFFSET READINGS

Position	From south	From north	Width
Top	1340	1450	575
Bottom	1330	1395	575

PIPE REGISTER

A East wall: dia. 40; centre 1200 above main roof.


B South wall: dia. 22; near soffit.

C South wall: dia. 150; at base flashing.

D North wall: dia. 70.

Local room datum = main roof 0.000.

POSITION ON MAIN ROOF

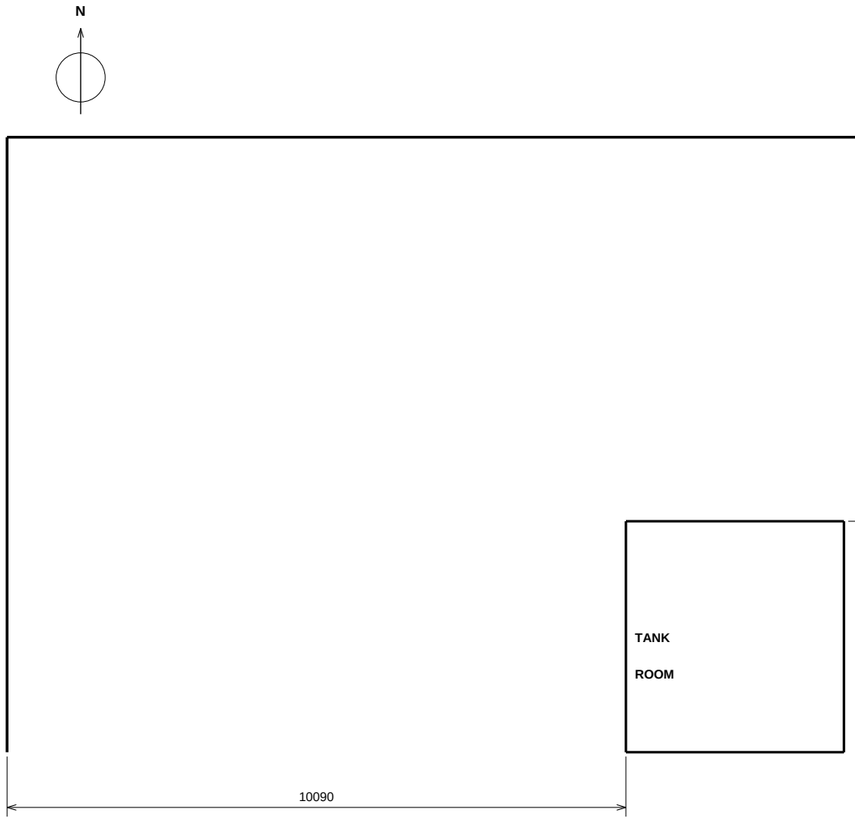

1 : 100 | Referenced wall faces to building edges

DRAWING NOTES

1. Existing tank room. Datum: main roof = 0.000.

2. North/south walls: brickwork. East/west walls: timber/cladding on raised kerbs.

3. Pipe A: centre 1200 above main roof. Pipe B-D heights shown diagrammatically.

4. Proposed steel frame, grillage and south bird-box boarding excluded.

ELEMENT KEY

Brick walls: 230 thick

Brick top: 1660 above main roof

West kerb: 270 wide x 230 high

East kerb: 240 wide x 230 high

Lead upstand: 340 high

Fascia: 240 deep

Rev	Issue	Drawn	Chkd	Date
TBC	REVIEW	ST	AF	01-11-26

Consultant:

KA ENGINEERING GROUP

Client: JetNSL

JET network solutions

Drawing Title:

Tank Room - Survey / Location

HOWMIC COURT


EXISTING WATER TANK ROOM

Drawn: ST Checked: AF

Details as noted / Context NTS

Project: 7092 Dwg: 7092-03


Revision: TBC

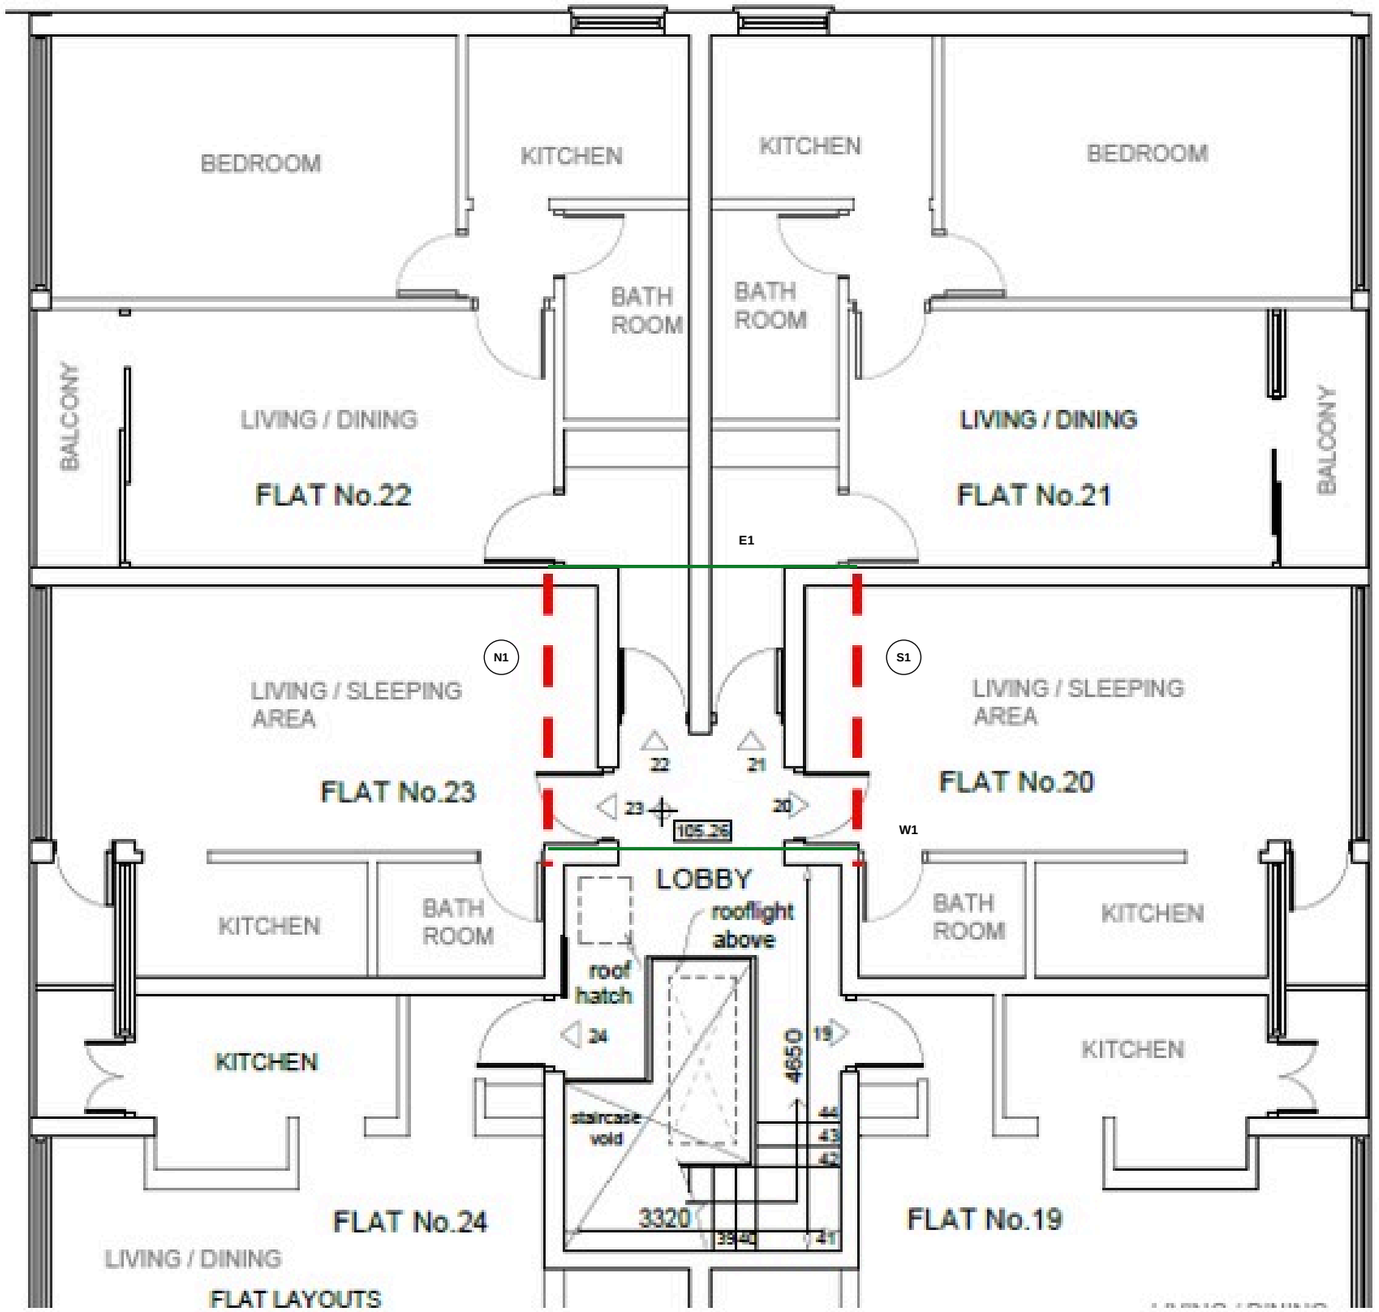

1 **Top-Floor Plan / Tank-Room Wall Projections**

NTS | Original image retained; green E/W timber walls above

STAIRWELL / ROOM ALIGNMENT

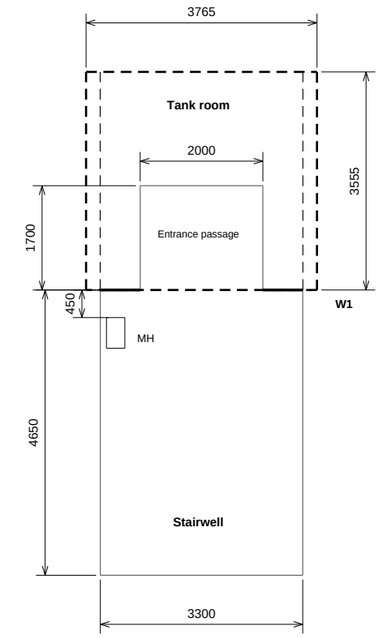

W1: west wall / N-S return line

DIMENSIONS IN mm; LEVELS RELATIVE TO MAIN ROOF

DRAWING NOTES

1. Green E1/W1: east/west timber-wall projections as marked by the engineer. Source red lines: N/S brick walls.

ELEMENT KEY

Image: original apartment layout

Green E1 / W1: timber walls above

Source red: N/S brick projections

W1: west wall / stairwell return

Rev	Issue	Drawn	Chkd	Date
TBC	REVIEW	ST	AF	01-11-26

Consultant:

KA ENGINEERING GROUP

Client: JetNSL

JET network solutions

Drawing Title:

Roof Support Layout

HOWMIC COURT

EXISTING WATER TANK ROOM

Drawn: ST Checked: AF

Plan / alignment references NTS

Project: 7092 Dwg: 7092-04

Revision: TBC