
ROOF LAYOUT - REFERENCE OVERLAYS

ENGINEER-MARKED WALL REFERENCES | WRITTEN SURVEY DIMENSIONS GOVERN | NTS | FOR REVIEW

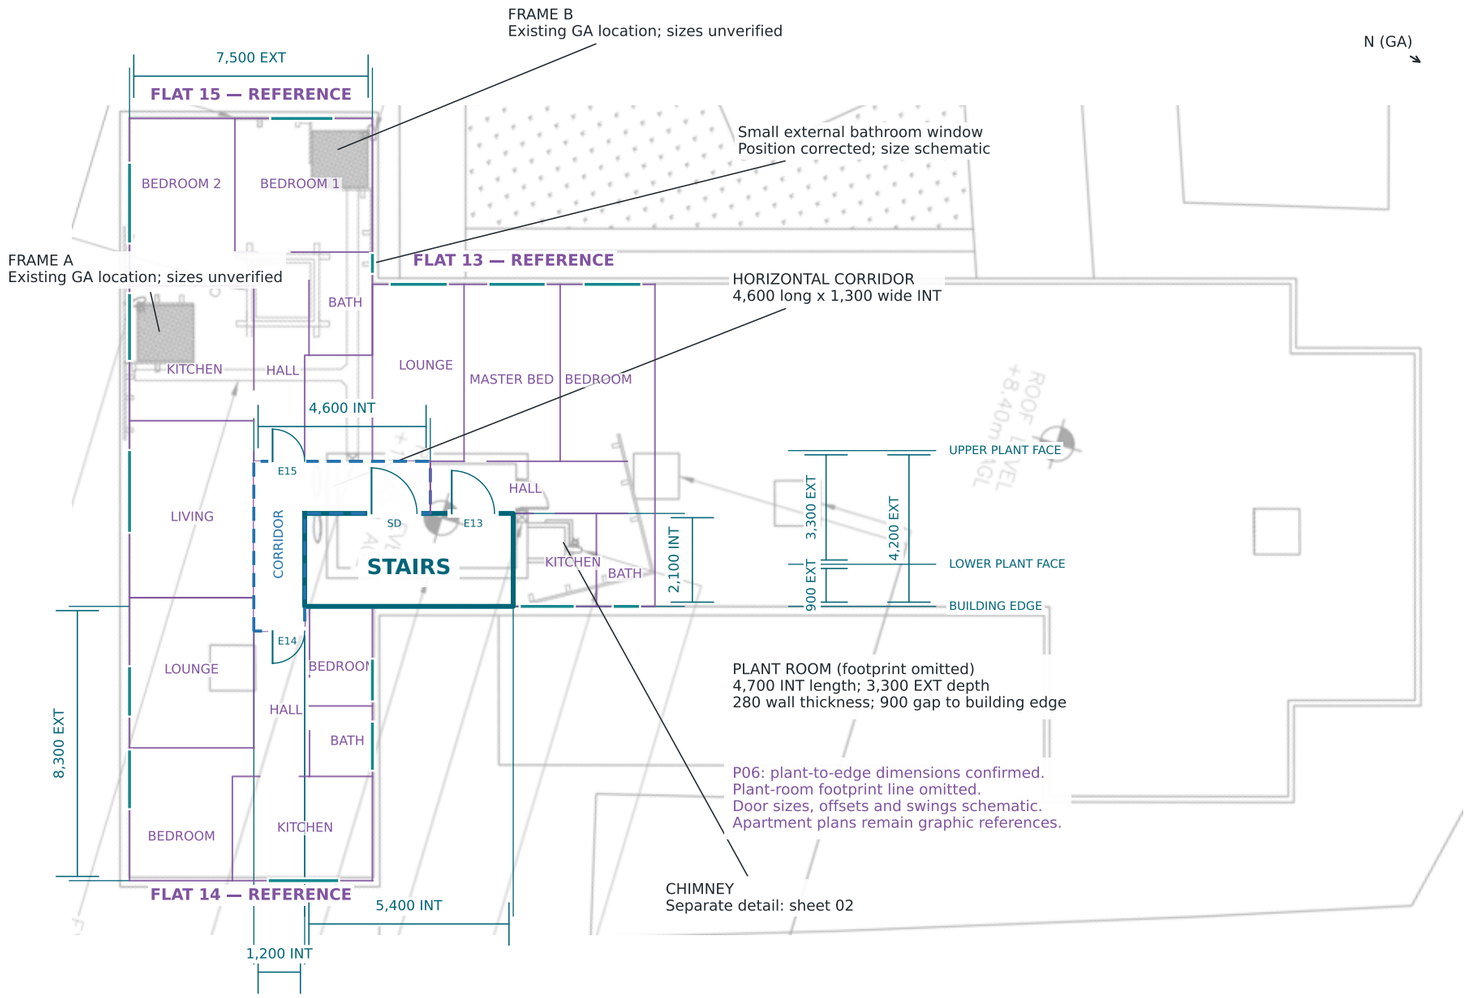

DIMENSION REFERENCES:

Stairwell: 5,400 x 2,100 INT. Upper corridor: 4,600 x 1,300 INT. Left corridor: 1,200 INT wide.
Plant upper face to building edge: 4,200 EXT = 3,300 plant depth + 900 gap.
Separate upper 4,200 EXT source label retained for review: endpoints not yet established.

Dimensions are written survey values, not PDF-scaled lengths. Purple room lines are approximate website-plan references, not surveyed partitions.

INT = INTERNAL FACES; EXT = EXTERNAL FACES. VALUES IN mm; NTS. UNRESOLVED ENDPOINTS LISTED ON SHEET.

Sources: Survey Notes pp2-3; GA 200 Rev 1A (PDF p5); engineer boundary/corridor/window markup and exterior photographs.

ALL DIMENSIONS IN mm UNLESS STATED OTHERWISE

NOTES:

1. Top-floor flats 13-15 were inaccessible. Apartment plans are third-party references, not surveyed structure.

2. Internal overlay re-anchored to the wall lines marked by the engineer. Graphic fit is not a measured flat layout.

3. Stairs have separate doors to common corridor (SD) and flat 13 (E13). E14/E15 mark other flat entrances.

4. Plant-room footprint omitted as requested. Bedroom 14 extends to stair wall. Door/window sizes and swings schematic.

5. Stairwell 5,400 x 2,100 INT confirmed. Remaining dimension endpoints listed on drawing. Frame sizes/anchors unverified. Chimney: sheet 02.

STRUCTURAL MEMBER KEY

- Load-bearing stair walls — Engineer-described survey line
- Non-load-bearing corridors
- Apartment reference partitions — Structural status unverified
- Window reference from plan — Photo association, not measured
- Client GA / existing equipment
- Door leaf / swing (schematic)

Window marks are reference positions only.

P06	PLANT / EDGE	TBC	TBC	23-10-2026
Rev:	Issue:	Drawn:	Chkd:	Date:

Consultant:

KA ENGINEERING GROUP

Client:

Connect44

Job Title:

ROOF STRUCTURAL SURVEY

Drawing Title:

ROOF LAYOUT - REFERENCE OVERLAYS

Address:

HONEYPOT HALL
HAROLD ROAD
CLACTON-ON-SEA, ESSEX
CO15 6AL


Drawn By:	Checked By:
TO CONFIRM	TO CONFIRM
Scale at A3:	Date (reference sheet):
NTS / DO NOT SCALE	23-10-2026

Project No:	Drawing No:	Rev:
7111	7111-01	P06


CHIMNEY - X / Y FACE ELEVATIONS

ENGINEER-MARKED WALL REFERENCES | WRITTEN SURVEY DIMENSIONS GOVERN | NTS | FOR REVIEW

X FACE ELEVATION

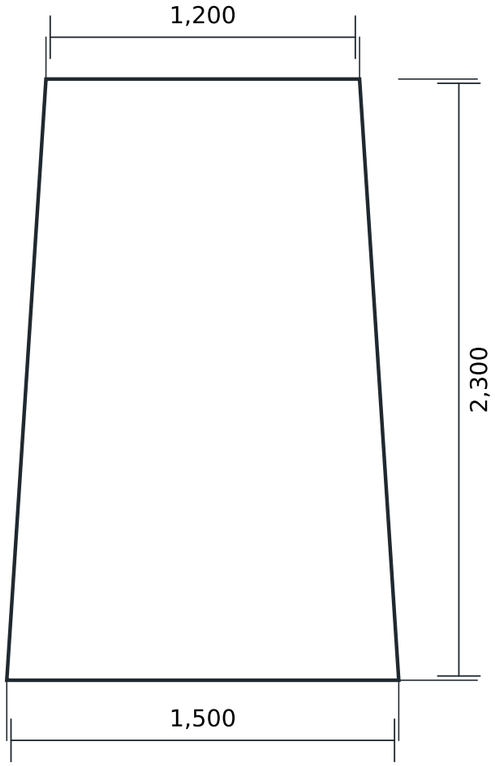

Y FACE ELEVATION

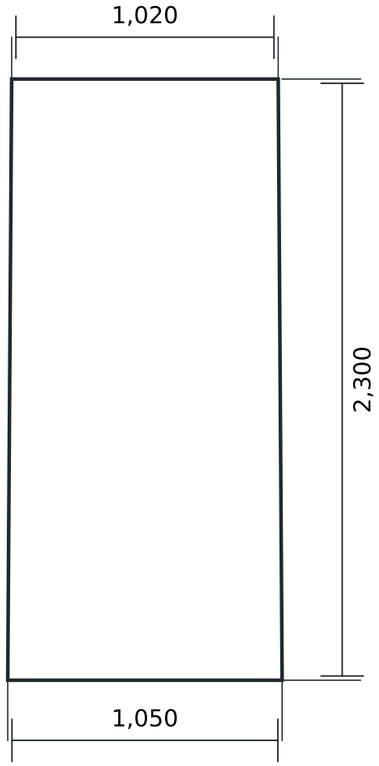

Confirmed dimensions: top 1,200 × 1,020; base 1,500 × 1,050; height 2,300 mm.
Faces shown centred for illustration. Taper distribution and X/Y orientation on GA are not established.
No steelwork, fixings, internal void, wall thickness or masonry strength inferred.

ALL DIMENSIONS IN mm. X / Y ARE THE TWO CHIMNEY FACES, NOT ASSUMED GA AXES.

Sources: Survey Notes pp2-3; GA 200 Rev 1A (PDF p5); engineer boundary/corridor/window markup and exterior photographs.

ALL DIMENSIONS IN mm UNLESS STATED OTHERWISE

NOTES:

1. Top: 1,200 x 1,020 mm. Base: 1,500 x 1,050 mm. Height: 2,300 mm. Engineer confirmed.

2. X and Y identify the rectangular faces. Their orientation on the GA remains unconfirmed.

3. Centred outlines are illustrative; taper eccentricity and face plumbness were not established.

4. Masonry thickness, internal voids, material strength and chimney-mounted steelwork are not established.

5. Dimensions show survey information, not capacity or anchor design. Roof layout is on sheet 01.

STRUCTURAL MEMBER KEY

— Chimney external outline
Survey dimensions confirmed

— Dimension / extension line

X / Y orientation on GA unconfirmed.

P06	PLANT / EDGE	TBC	TBC	23-10-2026
Rev:	Issue:	Drawn:	Chkd:	Date:

Consultant:

KA ENGINEERING GROUP

Client:

Connect44

Job Title:

ROOF STRUCTURAL SURVEY

Drawing Title:

CHIMNEY - X / Y FACE ELEVATIONS

Address:

HONEYPOT HALL
HAROLD ROAD
CLACTON-ON-SEA, ESSEX
CO15 6AL

Drawn By:	Checked By:
TO CONFIRM	TO CONFIRM
Scale at A3:	**Date (reference sheet):**
NTS / DO NOT SCALE	23-10-2026

Project No:	Drawing No:	Rev:
7111	7111-02	P06