
ROOF LAYOUT - REFERENCE OVERLAYS

ENGINEER-MARKED WALL REFERENCES | WRITTEN SURVEY DIMENSIONS GOVERN | NTS | FOR REVIEW

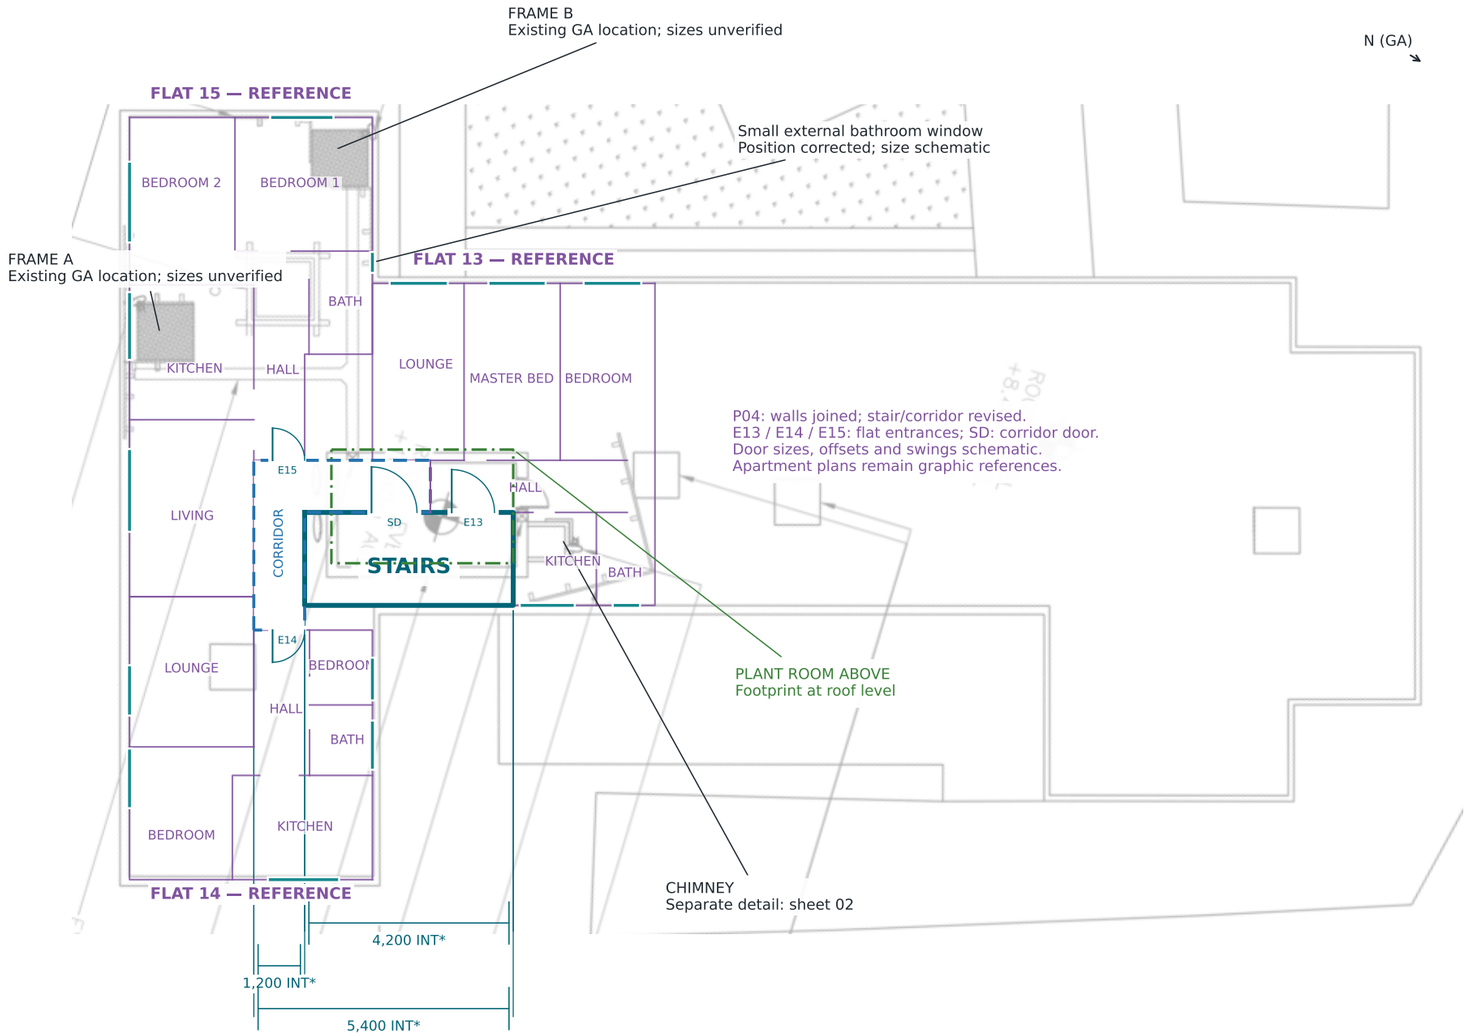

SURVEY READINGS FOR RECONCILIATION (source labels in metres; not all endpoints adopted):
Under-dot / EXT labels: 7.5; 4.6?; 4.2; 3.3; 4.2; 8.3. Other labels include 9.4?, 4.2, 5.4, 1.2 and an unclear stair depth.
Plant-room wall thickness noted as 0.28 m (280 mm); do not apply this to other walls. No PDF-scale dimensions inferred.

*Internal dimension readings / exact endpoints require review. Purple room lines are approximate traces of website plans, not surveyed partitions.

EXT = EXTERNAL WALL FACES (UNDER-DOT IN SOURCE). UNRESOLVED ENDPOINTS REMAIN FOR REVIEW.

Sources: Survey Notes pp2-3; GA 200 Rev 1A (PDF p5); engineer boundary/corridor/window markup and exterior photographs.

ALL DIMENSIONS IN mm UNLESS STATED OTHERWISE

NOTES:

1. Top-floor flats 13-15 were inaccessible. Apartment plans are third-party references, not surveyed structure.

2. Internal overlay re-anchored to the wall lines marked by the engineer. Graphic fit is not a measured flat layout.

3. Stairs have separate doors to common corridor (SD) and flat 13 (E13). E14/E15 mark other flat entrances.

4. Green footprint is plant room ABOVE; right wall aligns with stair/kitchen wall. Door/window sizes and swings schematic.

5. *Dimension readings/endpoints need review. Frame sizes/anchors unverified. Chimney is on sheet 02; no PDF-scale dimensions used.

STRUCTURAL MEMBER KEY

- Load-bearing stair walls — Engineer-described survey line
- Non-load-bearing corridors
- Apartment reference partitions — Structural status unverified
- Window reference from plan — Photo association, not measured
- Client GA / existing equipment
- Plant-room footprint ABOVE

Window marks are reference positions only.

P04	STAIRS / DOORS	TBC	TBC	23-10-2026
Rev:	Issue:	Drawn:	Chkd:	Date:

Consultant:

KA ENGINEERING GROUP

Client:

Connect44

Job Title:

ROOF STRUCTURAL SURVEY

Drawing Title:

ROOF LAYOUT - REFERENCE OVERLAYS

Address:

HONEYPOT HALL
HAROLD ROAD
CLACTON-ON-SEA, ESSEX
CO15 6AL


Drawn By:	Checked By:
TO CONFIRM	TO CONFIRM
Scale at A3:	Date (reference sheet):
NTS / DO NOT SCALE	23-10-2026

Project No:	Drawing No:	Rev:
7111	7111-01	P04


CHIMNEY - X / Y FACE ELEVATIONS

ENGINEER-MARKED WALL REFERENCES | WRITTEN SURVEY DIMENSIONS GOVERN | NTS | FOR REVIEW

X FACE ELEVATION

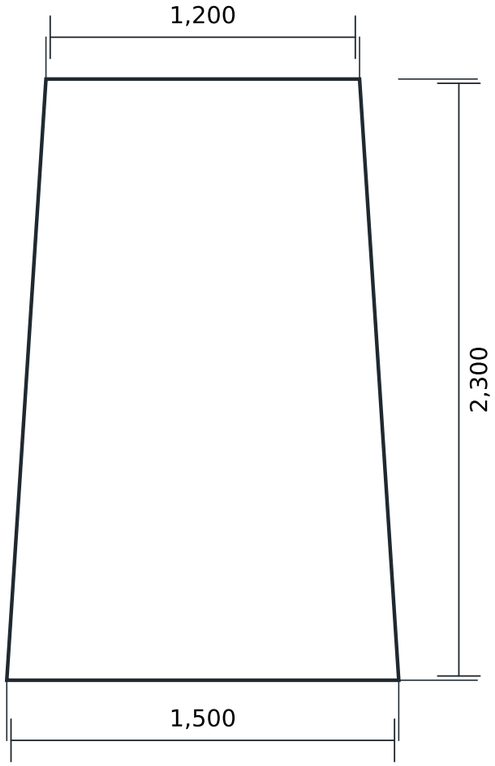

Y FACE ELEVATION

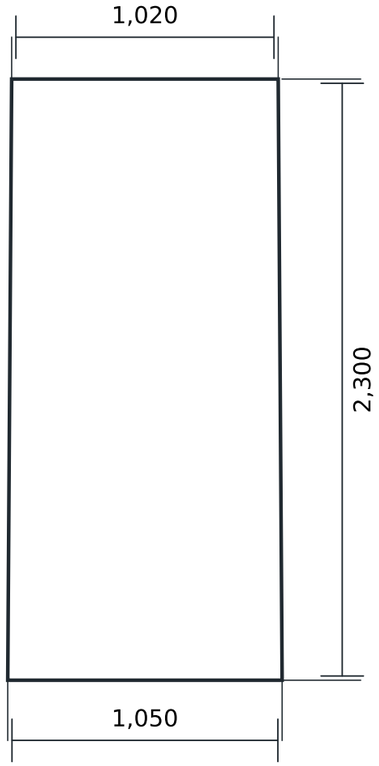

Confirmed dimensions: top 1,200 × 1,020; base 1,500 × 1,050; height 2,300 mm.
Faces shown centred for illustration. Taper distribution and X/Y orientation on GA are not established.
No steelwork, fixings, internal void, wall thickness or masonry strength inferred.

ALL DIMENSIONS IN mm. X / Y ARE THE TWO CHIMNEY FACES, NOT ASSUMED GA AXES.

Sources: Survey Notes pp2-3; GA 200 Rev 1A (PDF p5); engineer boundary/corridor/window markup and exterior photographs.

ALL DIMENSIONS IN mm UNLESS STATED OTHERWISE

NOTES:

1. Top: 1,200 x 1,020 mm. Base: 1,500 x 1,050 mm. Height: 2,300 mm. Engineer confirmed.

2. X and Y identify the rectangular faces. Their orientation on the GA remains unconfirmed.

3. Centred outlines are illustrative; taper eccentricity and face plumbness were not established.

4. Masonry thickness, internal voids, material strength and chimney-mounted steelwork are not established.

5. Dimensions show survey information, not capacity or anchor design. Roof layout is on sheet 01.

STRUCTURAL MEMBER KEY

— Chimney external outline
Survey dimensions confirmed

— Dimension / extension line

X / Y orientation on GA unconfirmed.

P04	STAIRS / DOORS	TBC	TBC	23-10-2026
Rev:	Issue:	Drawn:	Chkd:	Date:

Consultant:

KA ENGINEERING GROUP

Client:

Connect44

Job Title:
ROOF STRUCTURAL SURVEY

Drawing Title:
CHIMNEY - X / Y FACE ELEVATIONS

Address:
HONEYPOT HALL
HAROLD ROAD
CLACTON-ON-SEA, ESSEX
CO15 6AL

Drawn By:	Checked By:
TO CONFIRM	TO CONFIRM
Scale at A3:	**Date (reference sheet):**
NTS / DO NOT SCALE	23-10-2026

Project No:	Drawing No:	Rev:
7111	7111-02	P04