
ROOF LAYOUT - REFERENCE OVERLAYS

ENGINEER-MARKED WALL REFERENCES | WRITTEN SURVEY DIMENSIONS GOVERN | NTS | FOR REVIEW

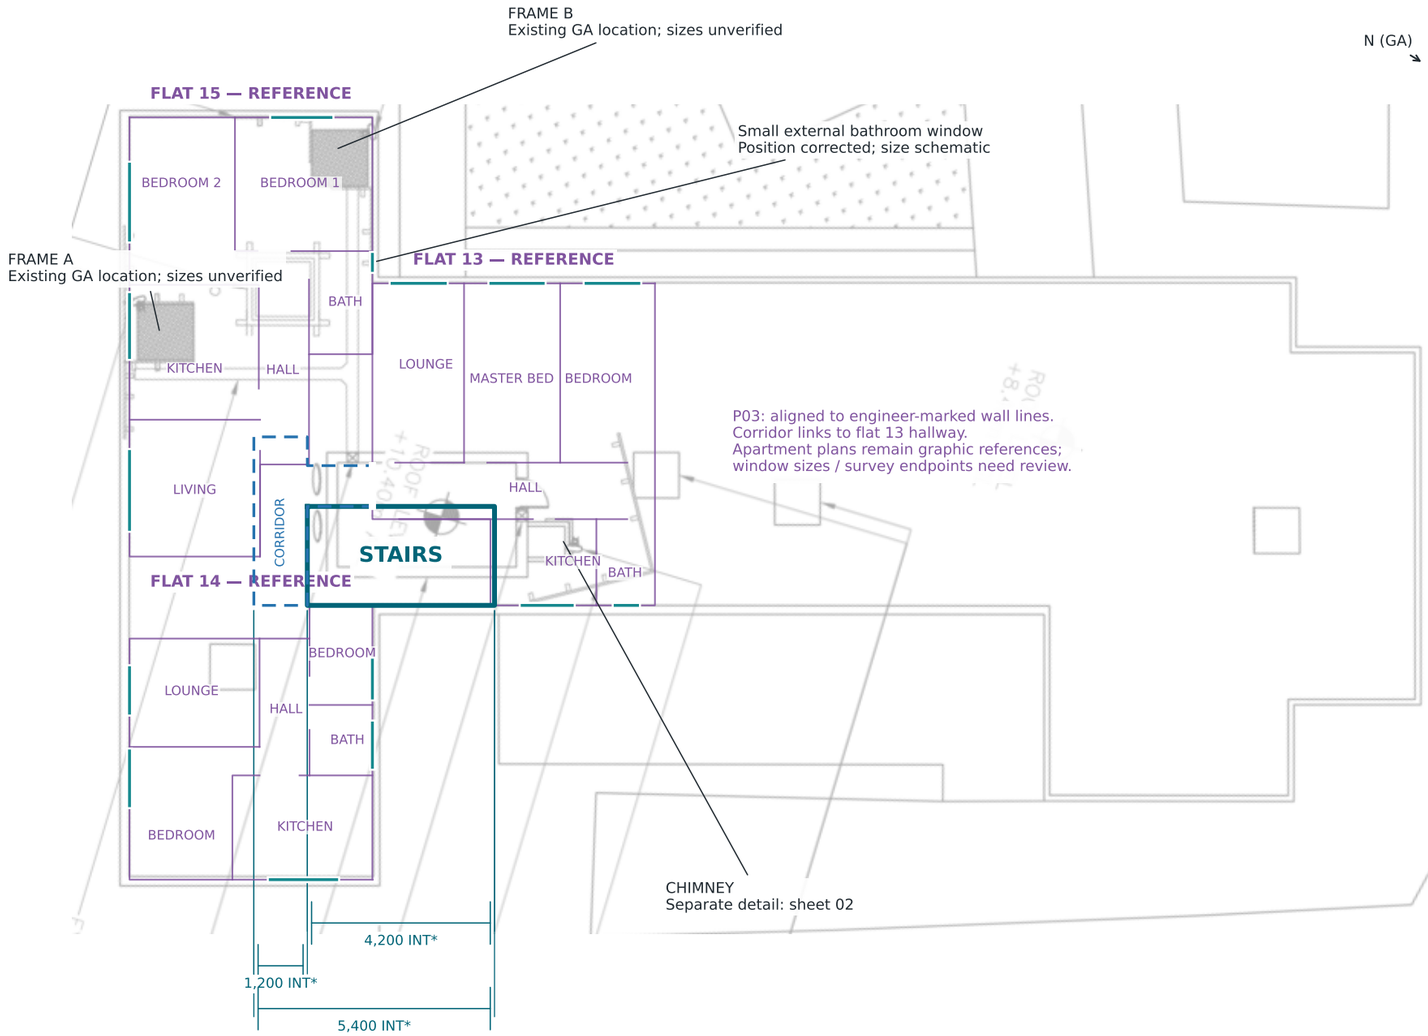

SURVEY READINGS FOR RECONCILIATION (source labels in metres; not all endpoints adopted):
Under-dot / EXT labels: 7.5; 4.67; 4.2; 3.3; 4.2; 8.3. Other labels include 9.4?, 4.2, 5.4, 1.2 and an unclear stair depth.
Plant-room wall thickness noted as 0.28 m (280 mm); do not apply this to other walls. No PDF-scale dimensions inferred.

*Internal dimension readings / exact endpoints require review. Purple room lines are approximate traces of website plans, not surveyed partitions.

EXT = EXTERNAL WALL FACES (UNDER-DOT IN SOURCE). UNRESOLVED ENDPOINTS REMAIN FOR REVIEW.

Sources: Survey Notes pp2-3; GA 200 Rev 1A (PDF p5); engineer boundary/corridor/window markup and exterior photographs.

ALL DIMENSIONS IN mm UNLESS STATED OTHERWISE

NOTES:

1. Top-floor flats 13-15 were inaccessible. Apartment plans are third-party references, not surveyed structure.

2. Internal overlay re-anchored to the wall lines marked by the engineer. Graphic fit is not a measured flat layout.

3. Communal corridor runs left of stairs and connects to flat 13 hallway. Dashed lines are non-load-bearing.

4. Flat 15 bathroom window moved to external wing wall. Opening size is schematic; no aperture dimension inferred.

5. *Dimension readings/endpoints need review. Frame sizes/anchors unverified. Chimney is on sheet 02; no PDF-scale dimensions used.

STRUCTURAL MEMBER KEY

- Load-bearing stair walls — Engineer-described survey line
- Non-load-bearing corridors
- Apartment reference partitions — Structural status unverified
- Window reference from plan — Photo association, not measured
- Client GA / existing equipment

Window marks are reference positions only.

P03	WALLS / LINK	TBC	TBC	23-10-2026
Rev:	Issue:	Drawn:	Chkd:	Date:

Consultant:

KA ENGINEERING GROUP

Client:

Connect44

Job Title:

ROOF STRUCTURAL SURVEY

Drawing Title:

ROOF LAYOUT - REFERENCE OVERLAYS

Address:

HONEYPOT HALL
HAROLD ROAD
CLACTON-ON-SEA, ESSEX
CO15 6AL

Drawn By:	Checked By:
TO CONFIRM	TO CONFIRM
Scale at A3:	Date (reference sheet):
NTS / DO NOT SCALE	23-10-2026

Project No:	Drawing No:	Rev:
7111	7111-01	P03